



May 18, 2010

In Reply Refer To:  
HSSD/CC-107

Mr. Pratip Lahiri  
Specifications and Standards Section, POD 23  
New York State Department of Transportation  
50 Wolf Road  
Albany, New York 12232

Dear Mr. Lahiri:

This letter is in response to your request for the Federal Highway Administrations (FHWA) acceptance of a roadside safety system for use on the National Highway System (NHS).

Name of system:	Type IIA Box Beam End Terminal
Type of system:	End Terminal
Test Level:	Modified MASH TL-3
Testing conducted by:	Midwest Roadside Safety Facility
Date of request:	November 10, 2009
Date of completed package:	April 13, 2010
Request initially acknowledged:	November 19, 2009

You requested that we find this system acceptable for use on the NHS under the provisions of the American Association of State Highway and Transportation Officials (AASHTO) Manual for Assessing Safety hardware (MASH).

### **Requirements**

Roadside safety devices should meet the guidelines contained in the AASHTO MASH. The FHWA Memorandum "Identifying Acceptable Highway Safety Features" of July 25, 1997, provides further guidance on crash testing requirements of longitudinal barriers.

### **Description**

The subject Type IIA End Terminal is a re-directive gating end terminal which is used with the New York State generic box beam guiderail (6 in. x 6 in. x 3/16 in. steel tube box beam). The cross section of the end terminal is identical to the generic box beam. The effective length of the Type IIA end terminal is 25 ft., 4 in., which includes a 17 ft., 11 7/8 in. shop-curved section and



8 ft., 3 1/16 in. straight section. The curved section has a radius of 35 ft. and 43 inches of the leading end of the straight section is turned down at a 1:2 slope. The end terminal requires 8 posts which are spaced approximately 3 ft. apart. Enclosure 1 shows the general layout of the New York State DOT Type IIA and details of each component.

### **Crash Testing**

According to MASH, test 3-30 through test 3-38 are to be conducted for end terminals. The point of impact in tests 3-30, 3-31, 3-32, and 3-33 are the face of the ramped part of the end terminal. However, New York State Department of Transportation's (NYSDOT) intention is to utilize the Type IIA End Terminal at locations where the available clear zone is limited to less than 5 feet behind the leading end of the terminal (e.g., relatively tight radius driveways). Due to the flared design of the end terminal, it is unlikely that a vehicle can collide with the face of the ramped part of the system. Even if such a collision occurs and the vehicle is not contained, the vehicle will enter the hazard free area. Consequently, we agree that these four tests can be waived if the end terminal is properly installed and its use is confined to locations described.

Different variations of the Type IIA end terminal were crash tested by the Midwest Roadside Safety Facility. The variation described above and shown in Enclosure 1 was crash tested according to MASH test 3-34. The test article passed the test. Enclosure 2 shows a summary of the test results.

The point of impact for Test 3-34 is the Critical Impact Point (CIP). By definition, the CIP is where the behavior of the test article changes from redirecting the impacting vehicle to either capturing the vehicle or allowing it to gate through the system. Normally the CIP is determined through detailed analysis of the end terminal or use of relevant computer programs. However, in the test conducted, the CIP was assumed and then verified by a full scale crash test.

Test 3-35 was conducted on a variation of the final Type IIA End Terminal and the test article passed the test (Enclosure 3). The difference between this test article and the final Type IIA end terminal is that post 2 and 4 were moved to the back side of the rail for the final Type IIA End Terminal. This change is not expected to have a significant effect on the performance of the terminal and we concur that the final design would also be expected to pass the test.

A modified version of test 3-35 was also conducted on the end terminal described above because the NYSDOT staff considered the modified test more critical than the test recommended in MASH due to the fact that the end terminal is flared back rather than straight. The difference between the modified 3-35 and MASH 3-35 is the point of impact. In the former, the point of impact was upstream of the beginning of Length of Need (LON) (the fifth post in Enclosure 1) and in the latter it was the beginning of LON. The test article passed the test and Enclosure 4 summarizes the test results.

Test 3-36 is required where the end terminal is attached to rigid barriers or other very stiff features. As long as the Type IIA End Terminal is used with the New York State generic box beam guiderail, this test is not applicable.

Test 3-37 is to examine the behavior of the end terminal during reverse direction impact. This test was not performed. The reason for this is that the device is not intended to be utilized in a location that can result in a reverse direction impact. This acceptance letter is provided with recognition that the described Type IIA End Terminal cannot be installed in locations where there is a potential for reverse direction impacts to encounter the flared /curved portion of the end terminal, such as a median.

Test 3-38 is not required because the subject end terminal does not possess significant attenuation capability.

### **Findings**

The system described above and detailed in the enclosed drawings is acceptable for use on the NHS under the range of conditions tested, when such use is acceptable to a highway agency, and when installed in a manner consistent with the following limitations:

- 1) The Type IIA End Terminal is limited to locations where the available clear zone is less than 5 feet behind the leading end of the terminal (e.g., relatively tight radius driveways).
- 2) The Type IIA End Terminal cannot be extended beyond an abrupt shoulder break such as a ditch because there is a higher potential for underride in such circumstances.
- 3) Because the Type IIA End Terminal was subjected to a reduced MASH test matrix, the use of these terminals should be supervised to ensure that they are not being placed in inappropriate locations. Also, installations shall be monitored to ensure that in-service performance results in improved crash behavior compared to box beam guiderail terminals currently in use.

Please note the following standard provisions that apply to FHWA letters of acceptance:

- This acceptance is limited to the crashworthiness characteristics of the systems and does not cover their structural features, or conformity with the Manual on Uniform Traffic Control Devices.
- Any changes that may adversely influence the crashworthiness of the system will require a new acceptance letter.
- Should the FHWA discover that the qualification testing was flawed, that in-service performance reveals unacceptable safety problems, or that the system being marketed is significantly different from the version that was crash tested, we reserve the right to modify or revoke our acceptance.
- You will be expected to supply potential users with sufficient information on design and installation requirements to ensure proper performance.
- You will be expected to certify to potential users that the hardware furnished has essentially the same chemistry, mechanical properties, and geometry as that submitted for acceptance, and that it will meet the crashworthiness requirements of the FHWA and the NCHRP Report 350.


- To prevent misunderstanding by others, this letter of acceptance is designated as number CC-107 and shall not be reproduced except in full. This letter and the test documentation upon which it is based are public information. All such letters and documentation may be reviewed at our office upon request.
- This acceptance letter shall not be construed as authorization or consent by the FHWA to use, manufacture, or sell any patented system for which the applicant is not the patent holder. The acceptance letter is limited to the crashworthiness characteristics of the candidate system, and the FHWA is neither prepared nor required to become involved in issues concerning patent law. Patent issues, if any, are to be resolved by the applicant.

Sincerely yours,

A handwritten signature in black ink, appearing to read "David A. Nicol". The signature is fluid and cursive, with a large initial "D" and "N".


David A. Nicol, P.E.  
Director, Office of Safety Design  
Office of Safety


Enclosure 1: Type IIA Box Beam Terminal System Details

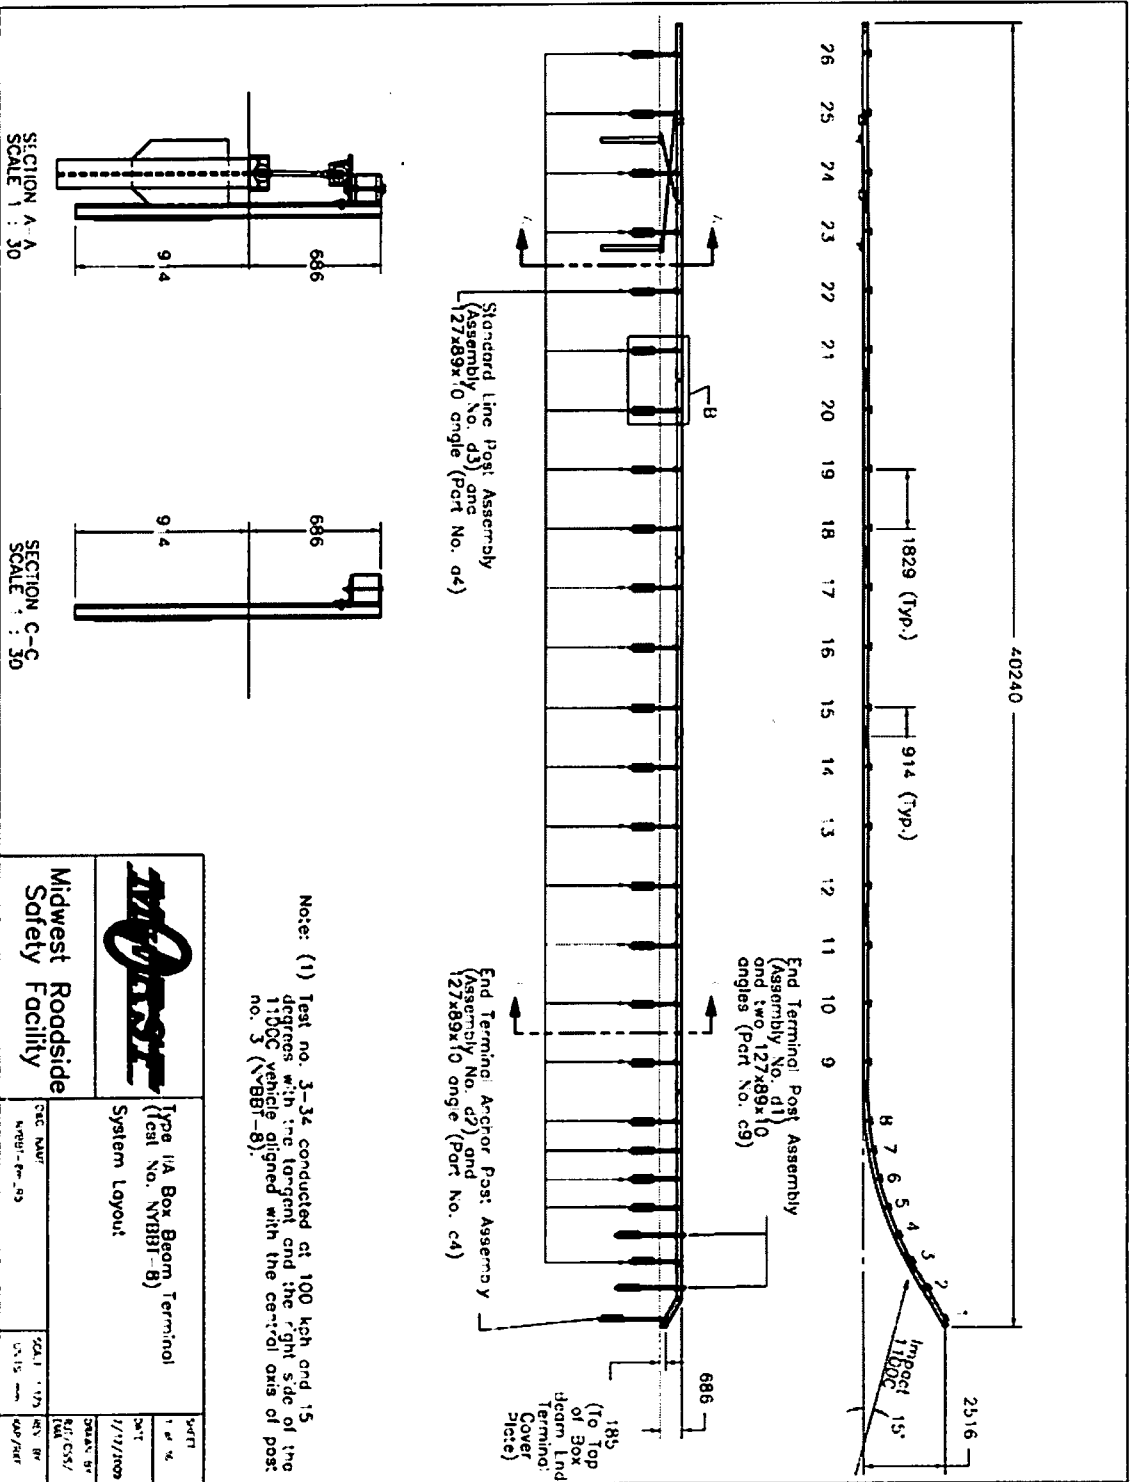

Note: (1) Test no. 3-34 conducted at 100 mph and 15 degrees with the tangent end the right side of the 1100C vehicle aligned with the central axis of post no. 3 (VBBT-8).

		Type IIA Box Beam Terminal		DATE	1/17/2009
		System Layout:		DRN: BT	1/17/2009
Midwest Roadside Safety Facility		CAC: MAF	SCALE: 1:30	SCALE: 1:30	SCALE: 1:30
		APP: BT-29	SCALE: 1:30	SCALE: 1:30	SCALE: 1:30

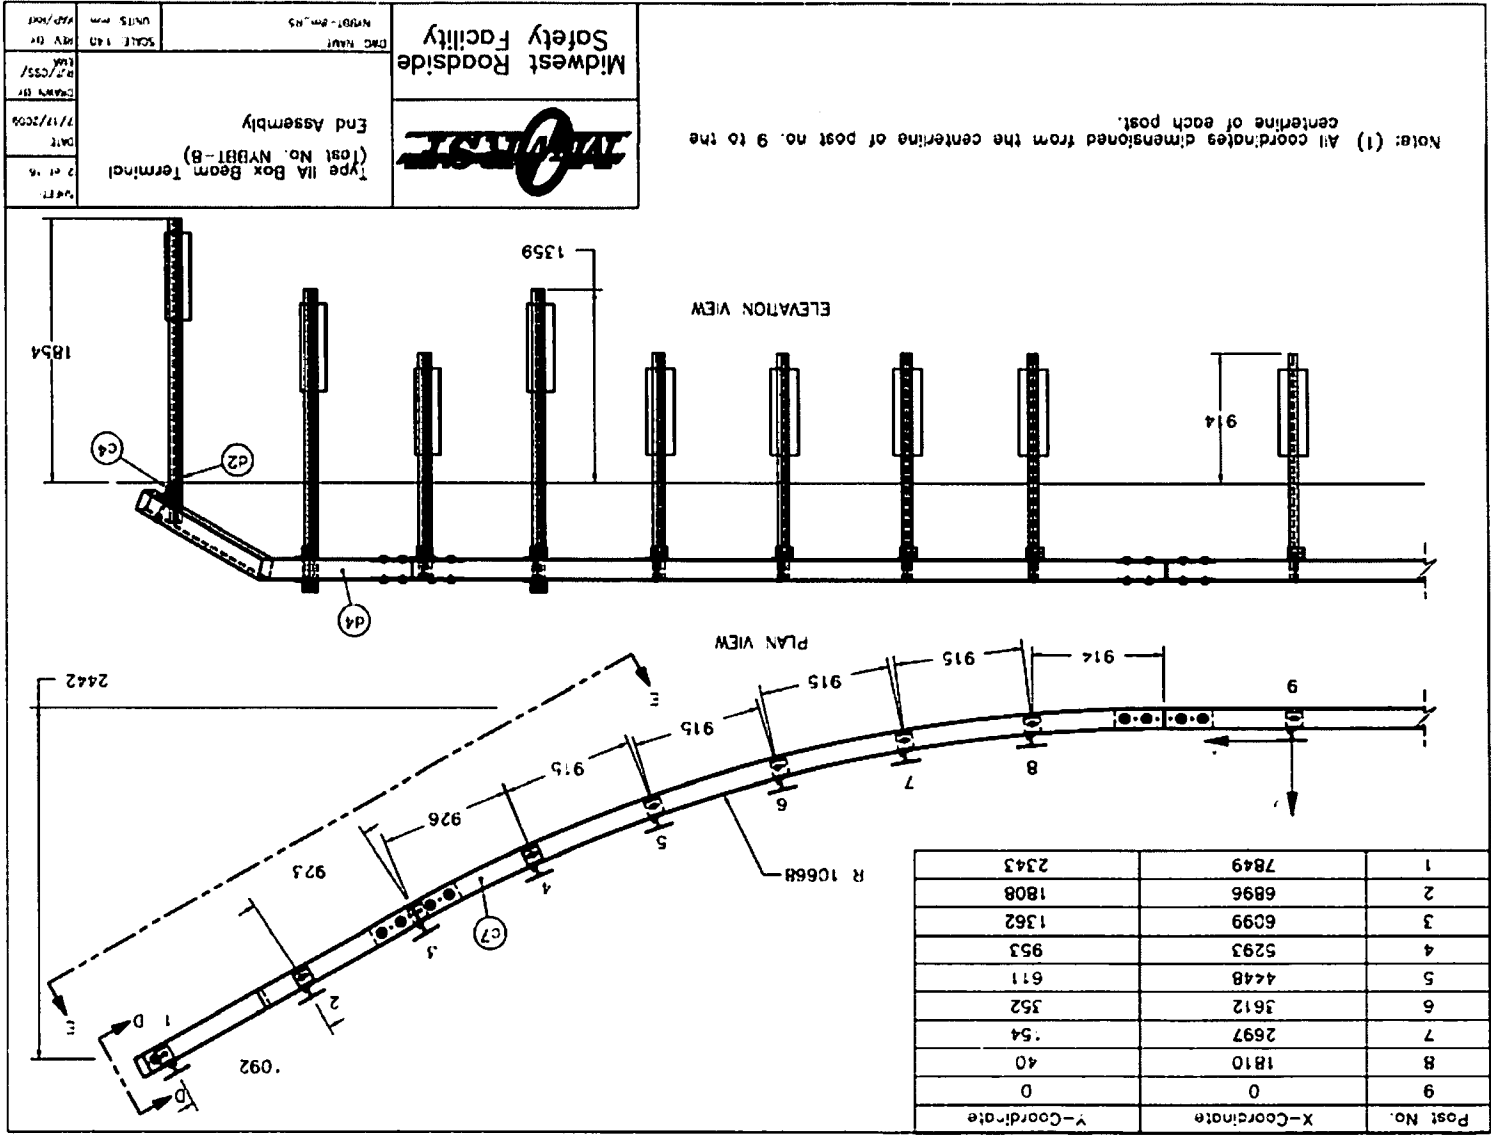

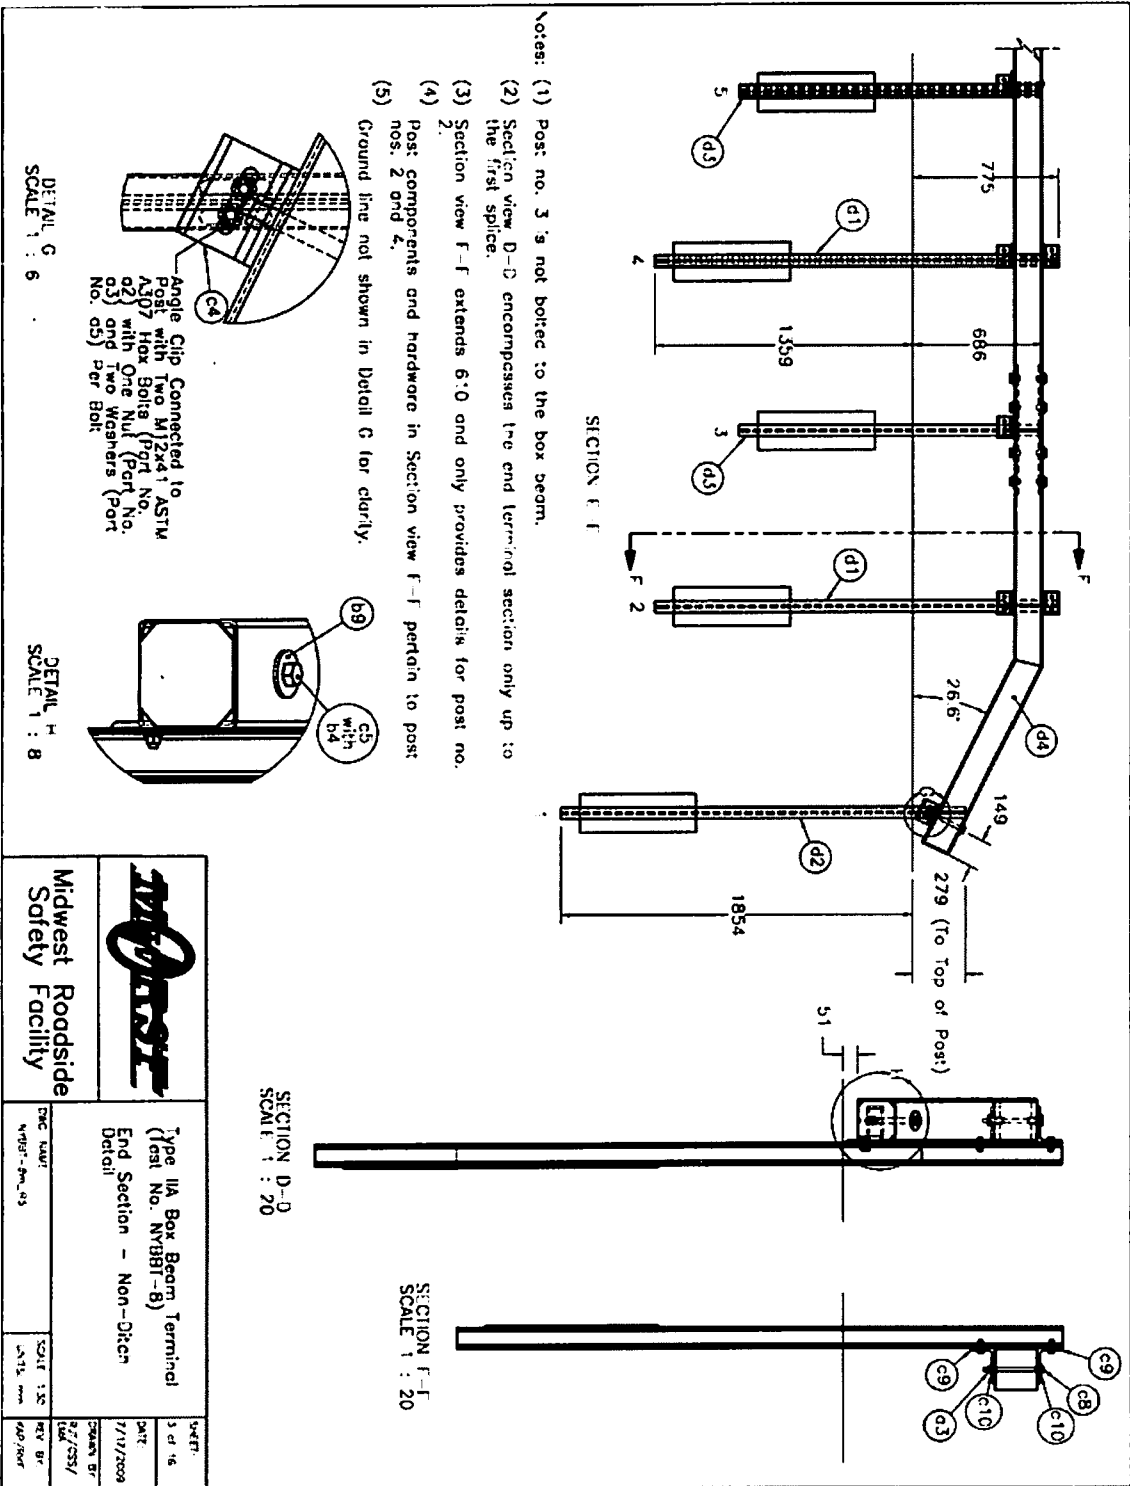

- (1) Post no. 3's not bolted to the box beam.
- (2) Section view D-D encompasses the end terminal section only up to the first splice.
- (3) Section view F-F extends 6'-0" and only provides details for post no. 2.
- (4) Post components and hardware in Section view F-F pertain to post nos. 2 and 4.
- (5) Ground line not shown in Detail G for clarity.

	Type IIA Box Beam Terminal (Test No. NYBBI-8) End Section - Non-Direct Detail		SHEET: 3 of 16
	DATE: 7/11/2009		REV BR: 92/CSJ/ ULM
	Dwg. No.: NYBBI-8n-03		SCALE 1/2" = 1'-0" DATE: 11/11/09


Midwest Roadside Safety Facility

DETAIL G  
 SCALE 1 : 6

DETAIL H  
 SCALE 1 : 8


SECTION D-D  
 SCALE 1 : 20

SECTION F-F  
 SCALE 1 : 20

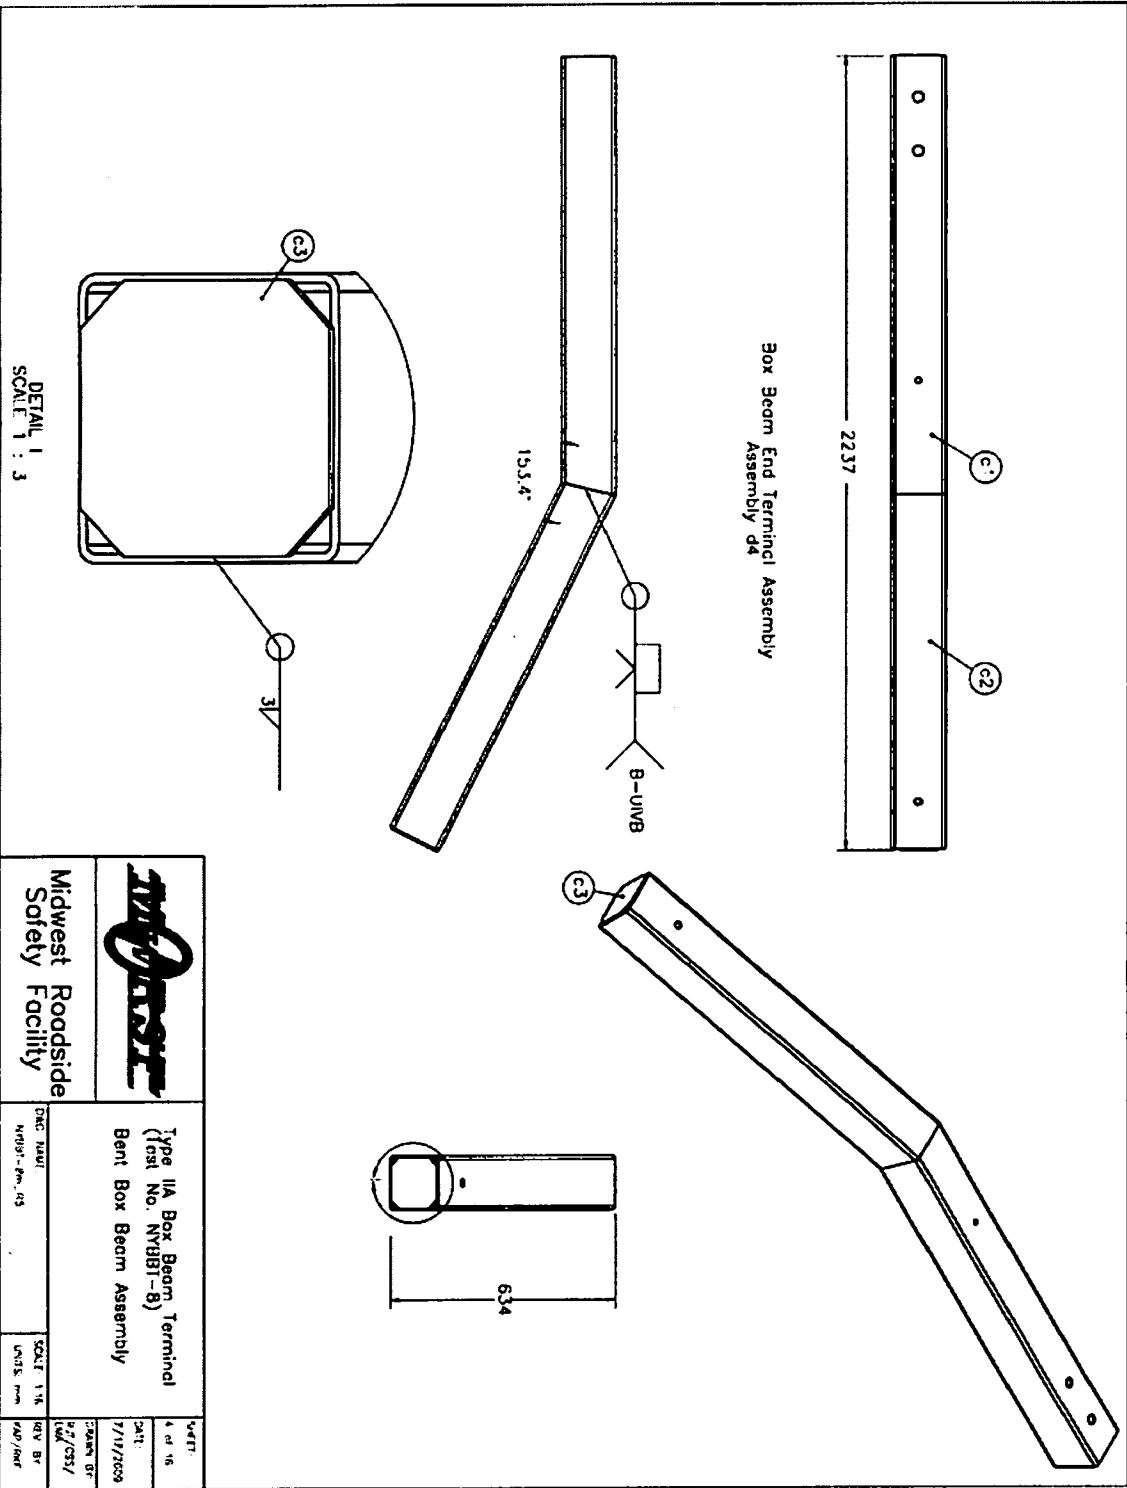


		<b>Type IIA Box Beam Terminal</b> (Inst. No. NY181-8) <b>Bent Box Beam Assembly</b>		QTY: 4 of 16 DATE: 7/17/2008 DRAWN BY: J.S./CST/ CHECKED BY: JAD/ROF
Proj. Name: NY181-8m-13	Scale: 1/8" Units: mm	Dec. 23, 2009 TRP-03-203-09		



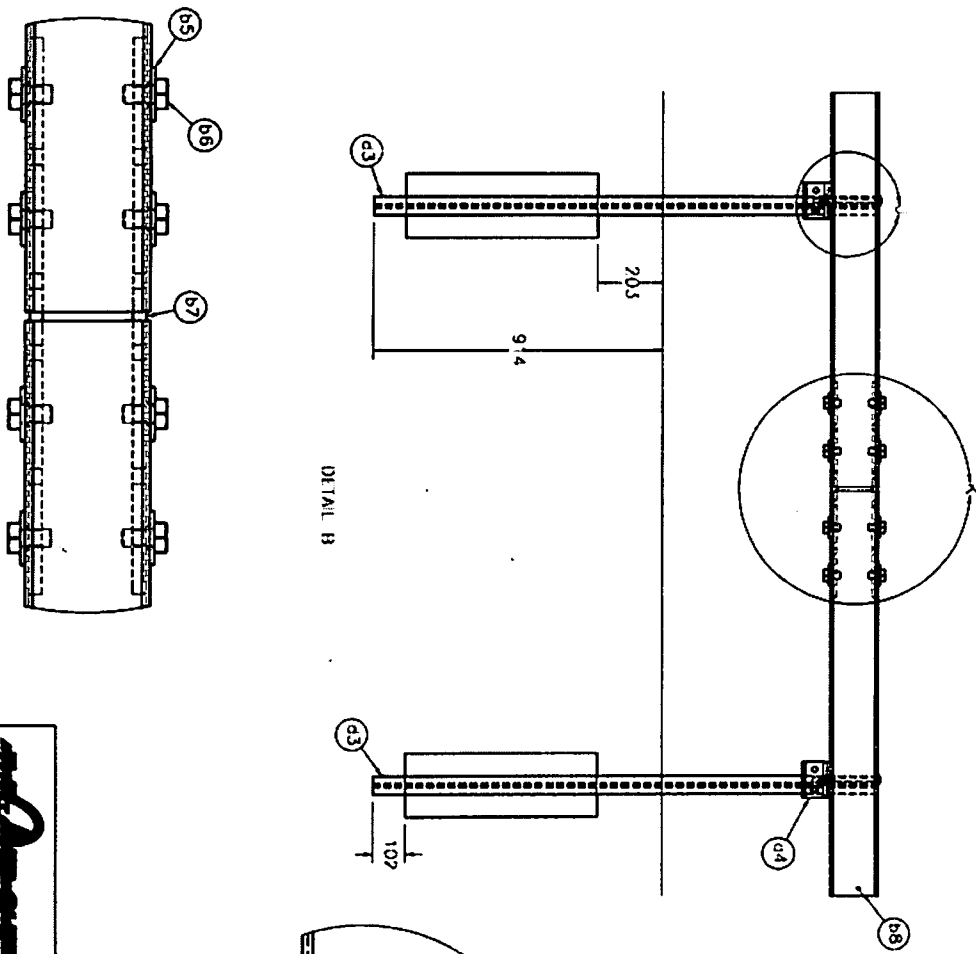


DETAIL B


DETAIL K  
SCALE 1 : 7  
Traffic-Side View

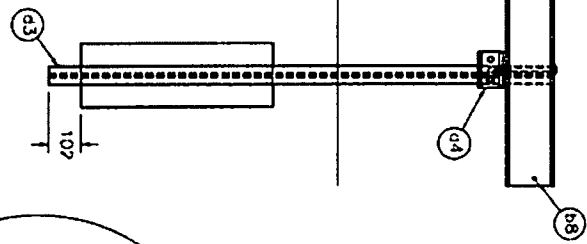


DETAIL J  
SCALE 1 : 5

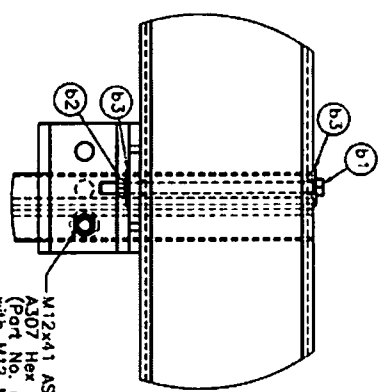


DETAIL I  
M12x41 ASIM  
A307 Hex Bolt  
(Part No. c2)  
With M12 Narrow  
Washer (Part  
No. c5) and  
Hex Nut (Part  
No. c3)

	<p>Type I/A Box Beam Terminal (Part No. NVRBT-8) Splice Specifications</p>		<p>DATE 7/7/2009</p>	<p>DWG. NO. NRBT-8M-03</p>
	<p>SCALE 1/8"</p>	<p>SCALE 1/8"</p>	<p>REV. 16</p>	<p>DATE 4/27/04</p>

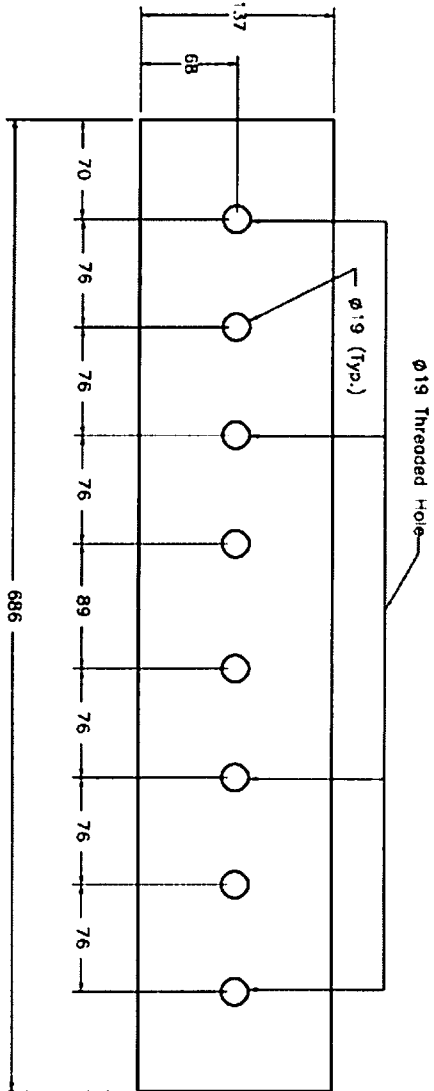

Splice Plate with Tapped Holes  
Part b7

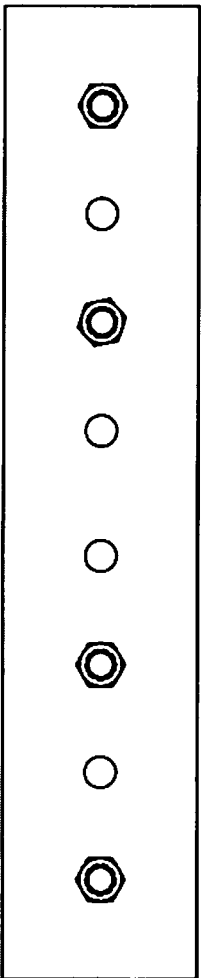

Splice Plate with Tack-Welded Nuts

Note: (1) Splice plates with tack-welded nuts may be substituted for the splice plate with tapped holes.



Midwest Roadside  
Safety Facility


Type IIA Box Beam Terminal  
(Test No. NTRB1-B)  
Splice Plate Details

Orig. Date  
MRSF-06-93






Scale: 1:4  
Units: mm

Rev: 07  
1/11/2009  
Rd/CSJ/  
JPD/AND


Tack Weld All Nuts  
to Splice Plates  
Prior to Assembly

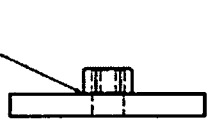


Sheet	4 of 4
Part	1/11/2009
Drawn By	Rd/CSJ/
Rev	07
Appr	AND

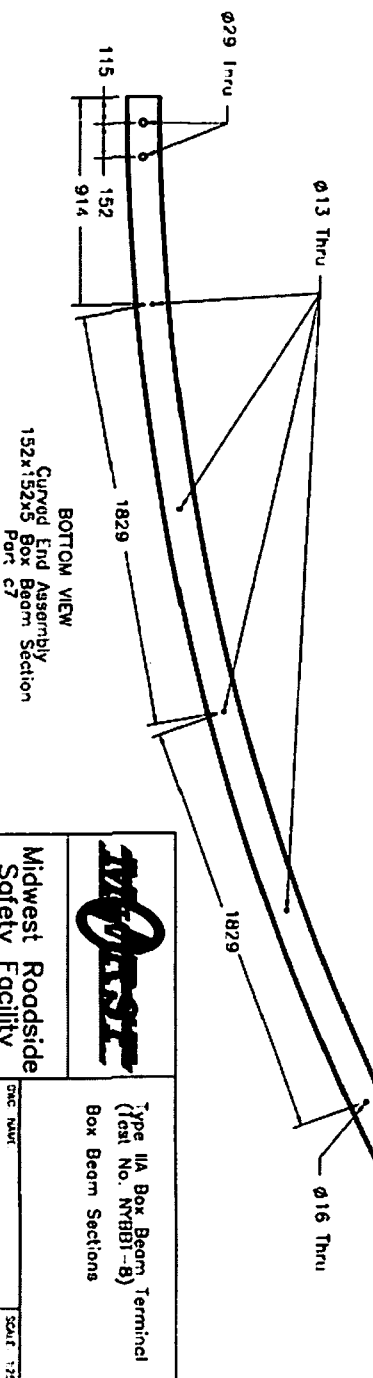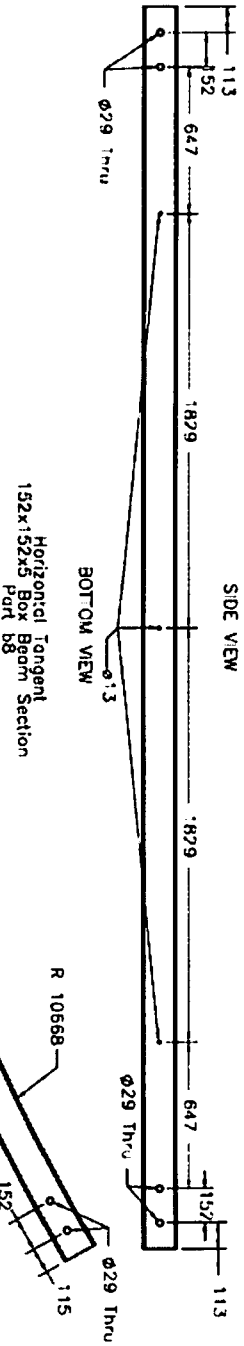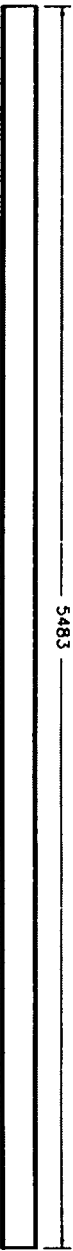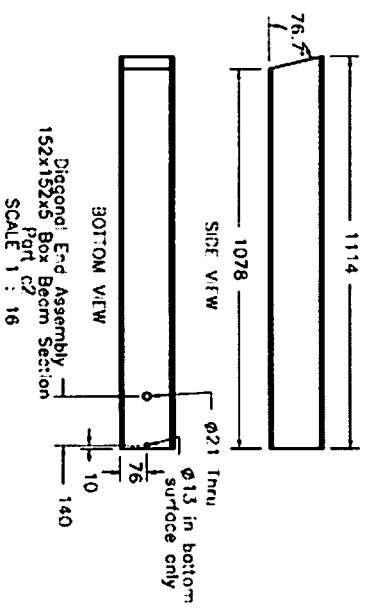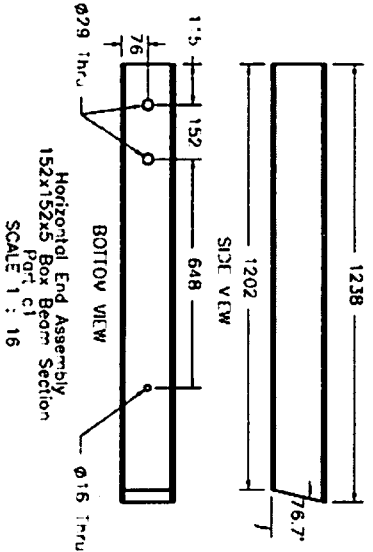

	<b>Type IIIA Box Beam Terminal</b> (Test No. NRBBI-8) Box Beam Sections	SHEET 2 of 16
		DATE 7/17/2009
Dwg. No. NRBBI-8m-A9	SCALE 1:16 UNITS mm	DESIGNED BY RJC/CSJ/
MIDWEST Roadside Safety Facility	DRAWN BY JEM	CHECKED BY JEM/POB



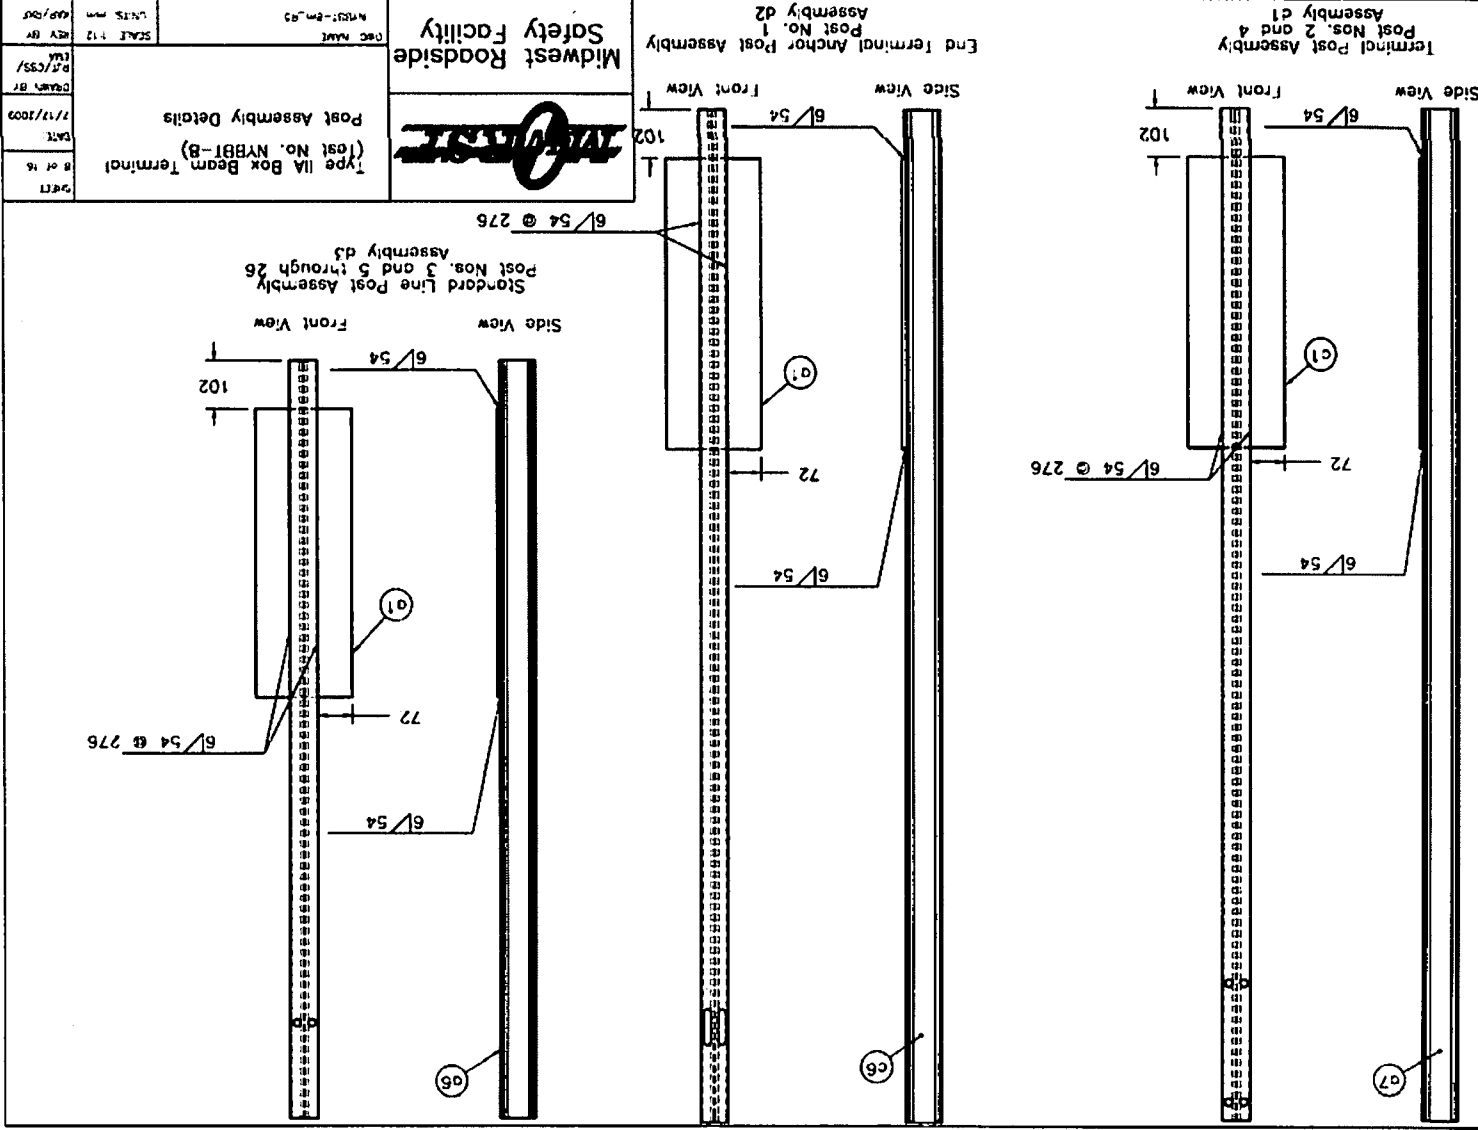



DATE	7/17/2009
SCALE	1:12
REV	BR
DATE	7/17/2009
SCALE	1:12
REV	BR
DATE	7/17/2009
SCALE	1:12
REV	BR


  
**Midwest Roadside**  
 Safety Facility

Type IIA Box Beam Terminal  
 Post Assembly Details  
 8 of 16  
 SHEET

Standard Line Post Assembly  
 Post Nos. 3 and 5 through 26  
 Assembly d5  
 End Terminal Anchor Post Assembly  
 Post No. 1  
 Assembly d2  
 Terminal Post Assembly  
 Post Nos. 2 and 4  
 Assembly c1

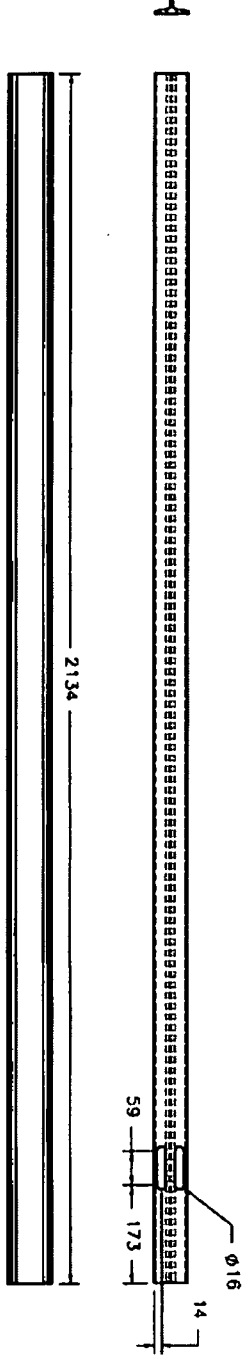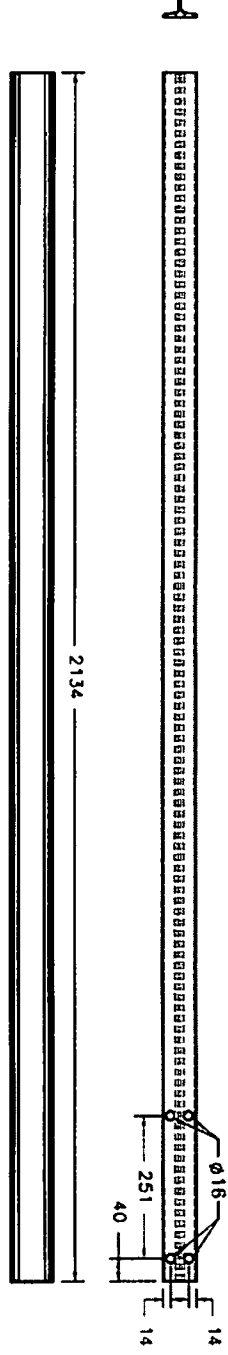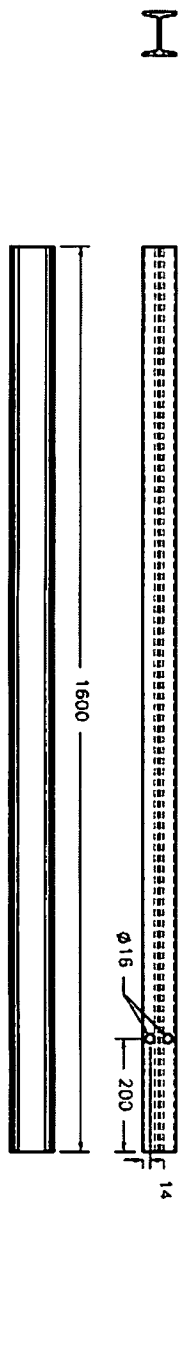


	Type I/A Box Beam Terminal (Test No. NRB1-8) General Post Details without Soil Plates		DATE 7/7/2009	DRAWN BY RJC/CSS/	CHECKED BY TMM
	Dwg Name NRB1-8m_A3	SCALE 1:10	UNITS mm	REV 01	DATE 4/27/09

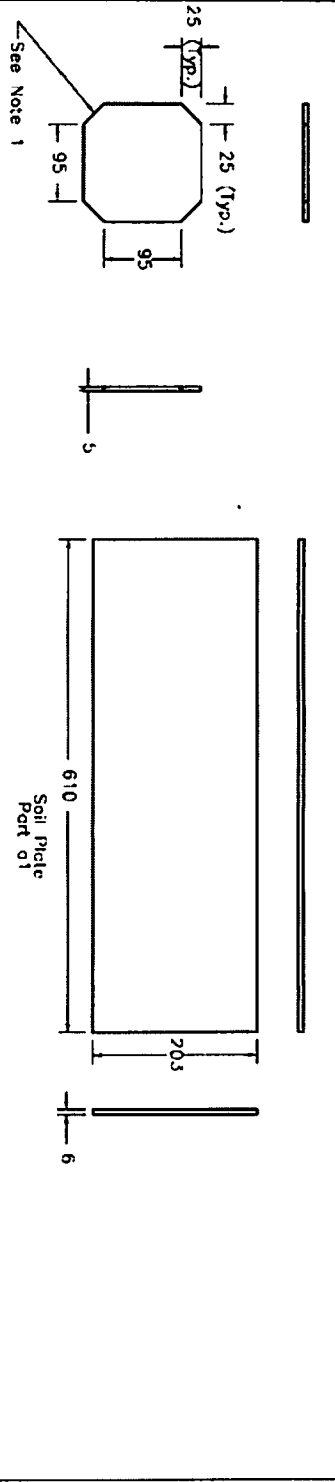


End Assembly Cover Plate  
Part C3


Note: (1) Corners of cover plate may be chamfered to assist drainage.

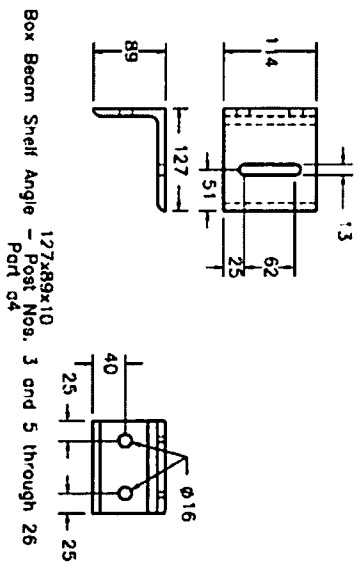

127x89x10  
Box Beam Shelf Angle  
Part C4

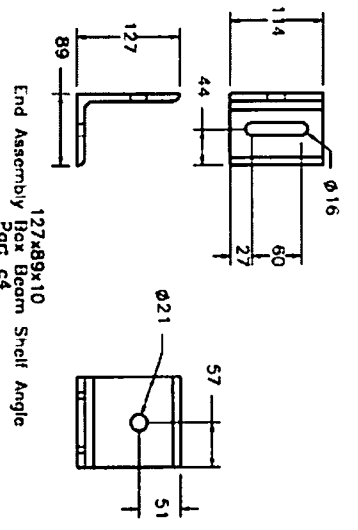


127x89x10  
End Assembly Box Beam Shelf Angle  
Part C4

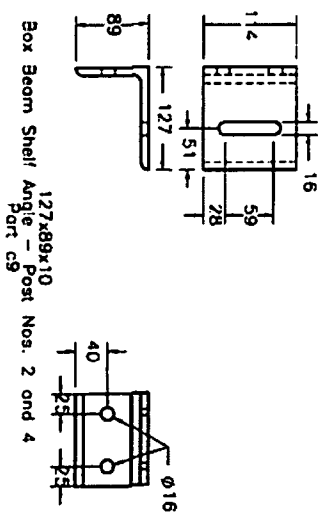


127x89x10  
Box Beam Shelf Angle  
Part C8


	Type IIA Box Beam Terminal (Cast No. N7BBI-8) Terminal Component Details	DATE 1/17/2009	DRAWN BY P.F./CSJ/ L.M.	QTY BY 497/MS
		Dwg No. N7BBI-8m-03	SCALE 1:2 UNITS mm	DATE 1/17/2009

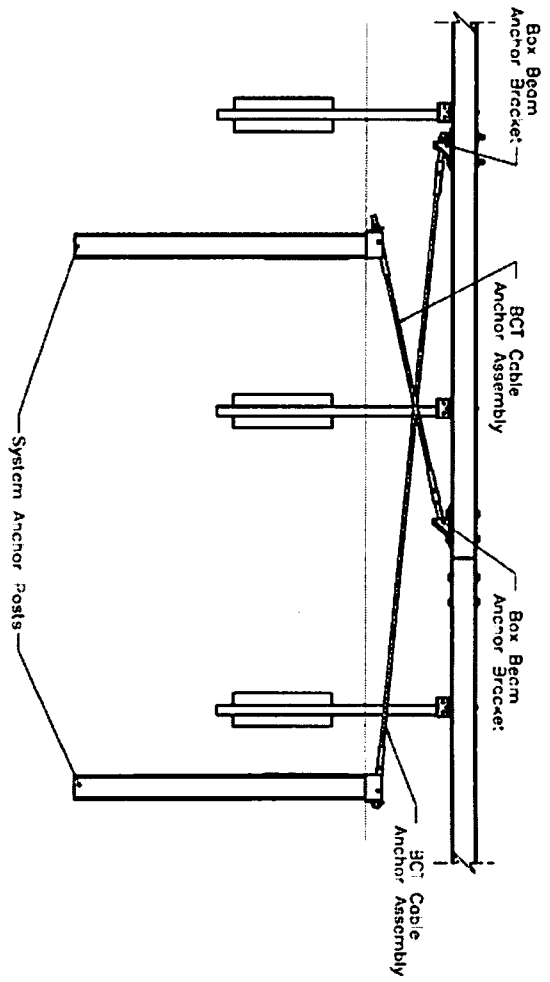


ELEVATION VIEW

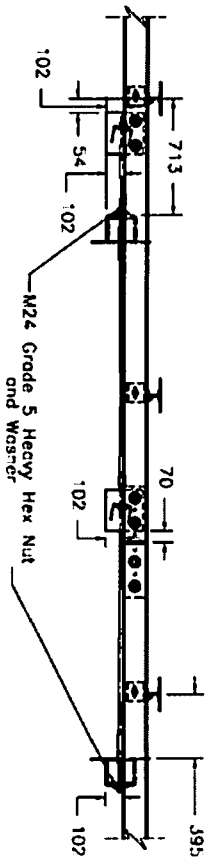

PLAN VIEW

 <b>Midwest Roadside Safety Facility</b>	<b>Type IIA Box Beam Terminal</b> (Test No. NYBB1-B) Downstream Anchorage Systems		SHEET 11 of 16
	DATE MADE NYBB1-6m-83	SCALE 1:15 UNITS mm	DATE 1/11/1009
		DATE 4/27/04	DRAWN BY PCL/CSS/





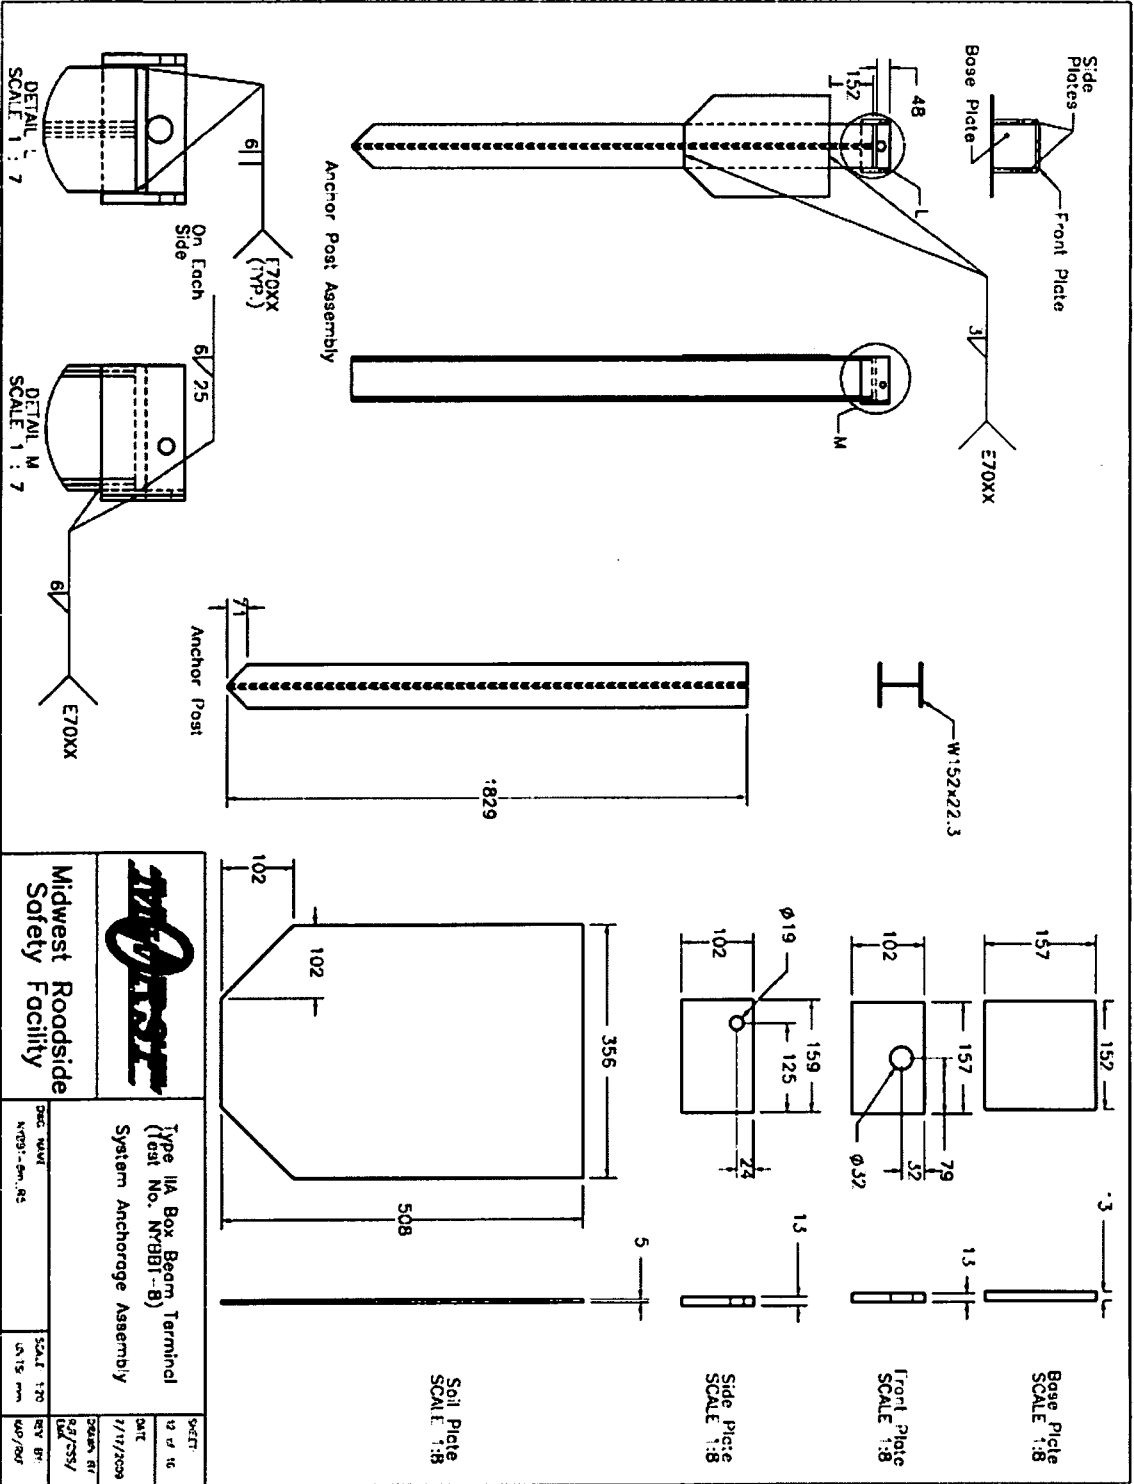


	<b>Midwest Roadside Safety Facility</b>	<b>TYPE IIA</b> <b>Box Beam Terminal</b> <b>(Test No. NRB1-B)</b> <b>System Anchorage Assembly</b>	SHEET 12 of 16
			DATE 7/17/2008
Proj. Name NRB1-6m.05	SCALE 1:8	Design By JG/CSH/	REV. BY 407/RS




DATE	13 of 18	TYPE IIA Box Beam Terminal (Test No. NYHBT-8)	SCALE 1 : 6
REV	14	Cable Anchor Bracket and Anchor Cable Details	SCALE 1 : 6
REV	13	NYHBT-8M-13	UNITS mm
REV	12	NYHBT-8M-13	SCALE 1 : 6


Midwest Roadside Safety Facility

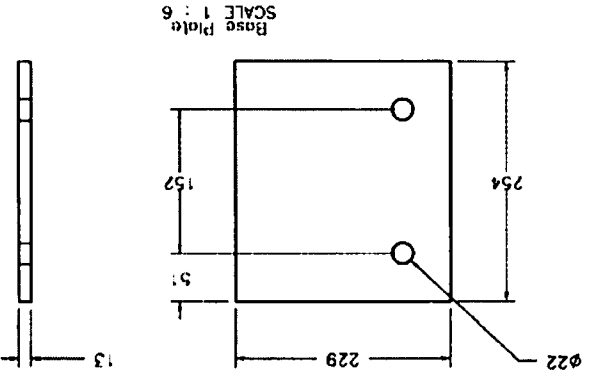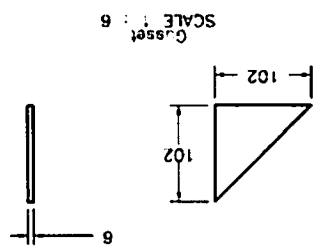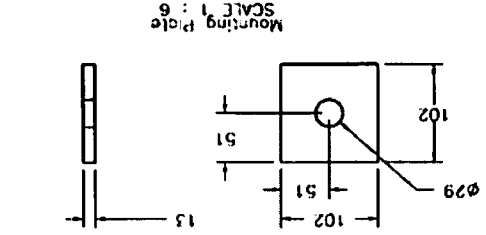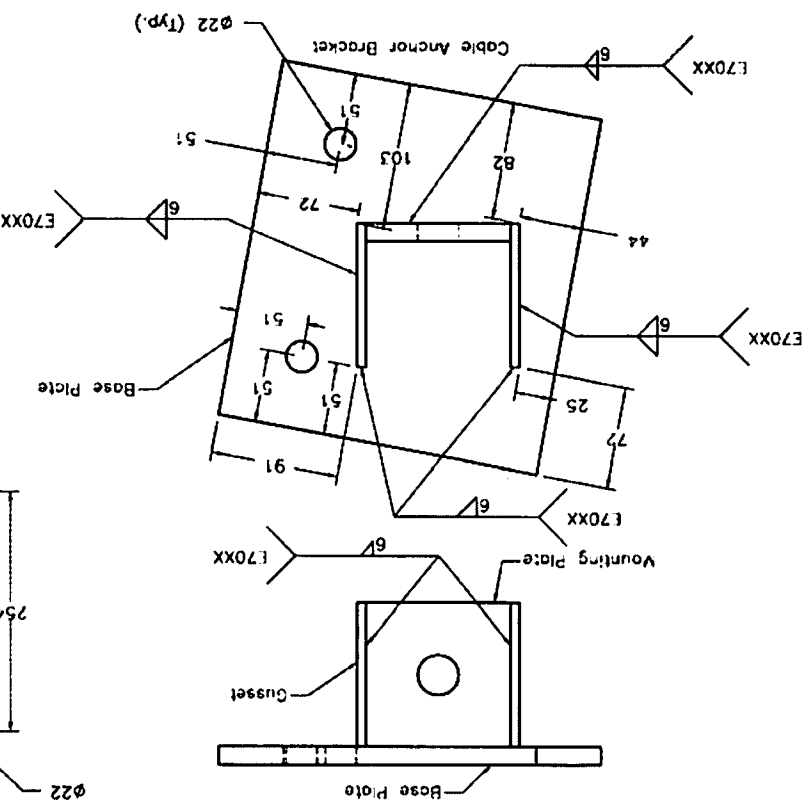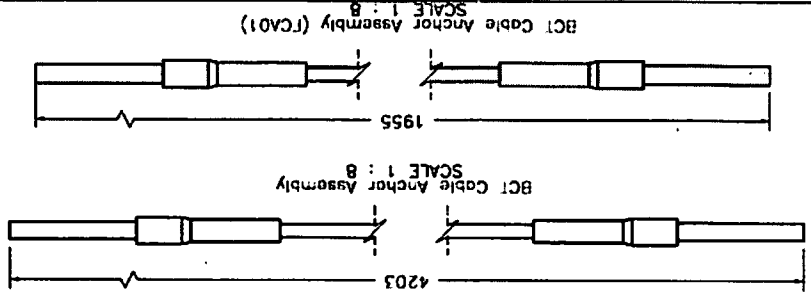

Test No. NYBBT-8			
Item No.	Quantity	Description	Material Specifications
a1	26	6 x 203 x 610mm steel soil plate	A36 Steel
a2	29	M12 coarse thread, 41mm long hex bolt	ASTM A307
a3	31	M12 hex nut	ASTM A307
a4	23	127 x 89 x 10mm box beam shelf angle	A36 Steel
a5	31	M12 narrow washer	ASTM A307
a6	23	S76 x 8.5, 1600mm long post	A36 Steel
a7	2	S76 x 8.5, 2134mm long post	A36 Steel
b1	22	M10 coarse thread, 191mm long hex bolt	ASTM A307
b2	22	M10 hex nut	ASTM A307
b3	44	M10 wide washer	ASTM A307
b4	1	M20 hex nut	ASTM A307
b5	56	M20 wide washer	ASTM A325
b6	56	M20 coarse thread, 38mm long hex bolt	ASTM A325
b7	14	686 x 137 x 16mm splice plate	A36 Steel
b8	6	152 x 152 x 5mm by 548.5mm long box beam	ASTM A500 Grade B
b9	1	M20 wide washer	ASTM A307
c1	1	End assembly bent: 152 x 152 x 5mm box beam	ASTM A500 Grade B
c2	1	End assembly diagonal 152 x 152 x 5mm box beam	ASTM A500 Grade B
c3	1	End assembly 5mm thick cover plate	A36 Steel
c4	1	127 x 89 x 10mm box beam anchor post shelf angle	A36 Steel
c5	1	M20 coarse thread, 197mm long hex bolt	ASTM A307
c6	1	S76 x 8.5, 2134mm long post anchor post	A36 Steel
c7	1	152 x 152 x 5mm, R 10.67m Curved Box Beam	ASTM A500 Grade B
c8	2	M12 coarse thread, 203mm long hex bolt	ASTM A307
c9	4	127 x 89 x 10mm box beam shelf angle with ø 16mm slot	A36 Steel
c10	4	M12 wide washer	ASTM A307
d1	2	Terminal Post Assembly	-
d2	1	Terminal Anchor Post Assembly	-
d3	23	Line Post Assembly	-
d4	1	Box Beam End Terminal Assembly	-


 <b>Midwest Roadside Safety Facility</b>	Type IIA Box Beam Terminal (Test No. NYBBT-8) Bill of Materials	SHEET 16 of 16 DATE 7/11/2009 DRAWN BY R.T./CSS/ [initials]
	DRC NAME NYBBT-8m_05	SCALE Name 1:15 mm

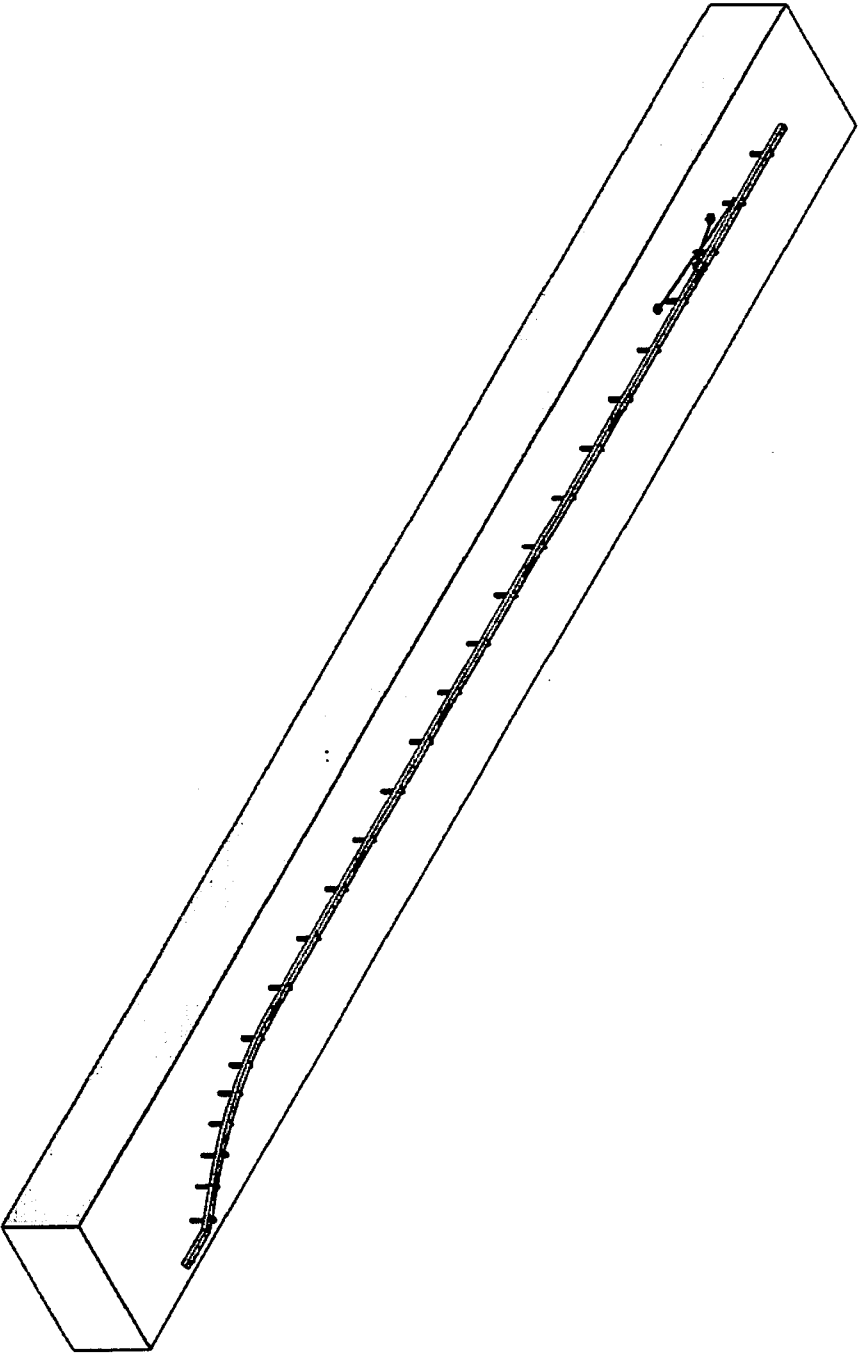


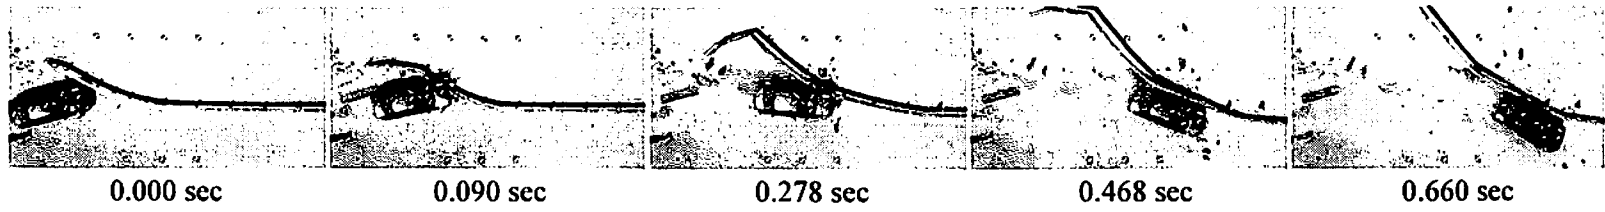
Midwest Roadside  
Safety Facility

Type IIA Box Beam Terminal  
(Post No. NYBBI-8)  
System Isometric


DATE	SCALE	DATE	BY
NYBBI-8m, 95	1:10	7/19/2009	492/207
DRWING	BY	DATE	BY
492/207	492/207	7/19/2009	492/207

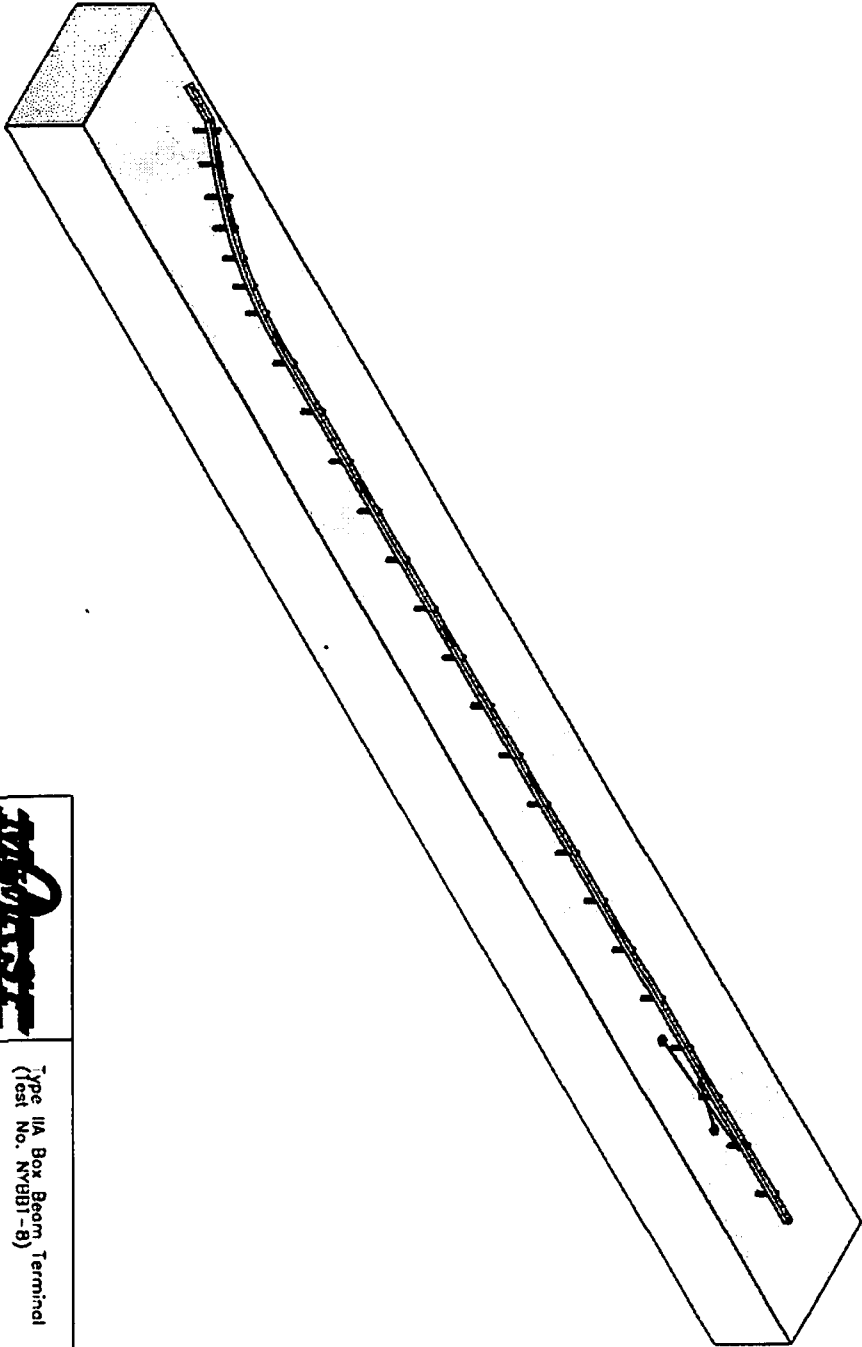

		<b>Type IIA Box Beam Terminal</b> <b>(Post No. NYBB1-8)</b> <b>System Isometric - As Built</b>		SHEET 16 of 16
		DATE 7/11/2008		DRAWN BY SJD/CSS/
<b>Midwest Roadside Safety Facility</b>		TYPIC NAME NYBB1-8m_03	SCALE: 1/32" 1:312.5 mm	REV BY JAO/ROF




- Test Agency ..... MwRSF
- Test Number ..... NYBBT-8
- Date ..... 7/15/09
- MASH Test Designation ..... 3-34
- Appurtenance ..... Modified Type IIA End Terminal
- Total Length ..... 40.2 m
- Key Element – Steel Box Beam
  - Size ..... 152 mm x 152 mm x 4.8 mm
  - Length ..... 5.486 mm
  - Top Mounting Height ..... 686 mm
- Key Elements - Steel Post
  - Post Nos. 1, 2, 4 ..... S76x8.5 by 2,134 mm long
  - Post Nos. 3, 5-26 ..... S76x8.5 by 1,600 mm long
- Type of Soil ..... Grading B - AASHTO M 147-65 (1990)
- Test Vehicle
  - Type/Designation ..... I100C
  - Make and Model ..... 2003 Kia Rto
  - Curb ..... 1,104 kg
  - Test Inertial ..... 1,106 kg
  - Gross Static ..... 1,183 kg
- Impact Conditions
  - Speed ..... 101.5 km/h
  - Angle ..... 16.9 degrees
  - Target Impact Location ..... Centerline of post no. 3
  - Actual Impact Location ..... 25 mm upstream of centerline of post no. 3
- Exit Conditions
  - Speed ..... 41.1 km/h
  - Angle ..... 25.7 degrees
  - Exit Box Criterion ..... Pass
- Post-Impact Trajectory
  - Vehicle Stability ..... Satisfactory
  - Stopping Distance ..... 24.3 m downstream
  - ..... 11.4 m laterally away traffic-side face
- Occupant Impact Velocity (EDR-3)
  - Longitudinal ..... -9.74 m/s < 12.2 m/s
  - Lateral ..... 4.36 m/s < 12.2 m/s

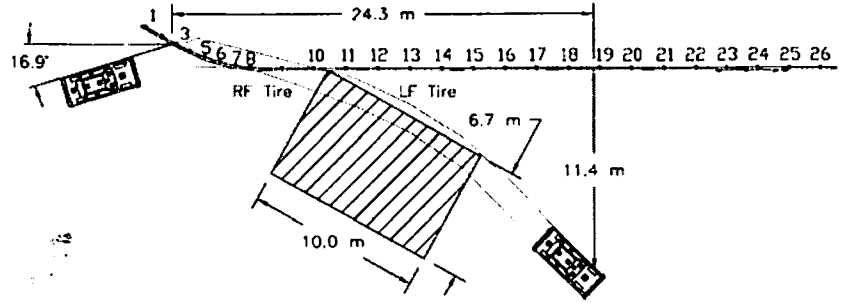

- Occupant Ridedown Acceleration (EDR-3)
  - Longitudinal ..... -11.15 g's < 20.49 g's
  - Lateral ..... 7.08 g's < 20.49 g's
- Occupant Impact Velocity (EDR-4)
  - Longitudinal ..... -9.34 m/s < 12.2 m/s
  - Lateral ..... 4.43 m/s < 12.2 m/s
- Occupant Ridedown Acceleration (EDR-4)
  - Longitudinal ..... -10.31 g's < 20.49 g's
  - Lateral ..... 5.62 g's < 20.49 g's
- THIV (EDR-4 - not required) ..... 9.51 m/s
- PHD (EDR-4 - not required) ..... 10.41 g's
- ASI (EDR-3 - not required) ..... 1.24
- ASI (EDR-4 - not required) ..... 1.16
- Test Article Damage ..... Moderate
- Test Article Deflections
  - Permanent Set ..... 2,842 mm
  - Dynamic ..... NA
  - Working Width ..... 6.6 m (estimate)
- Vehicle Damage ..... Moderate
  - VDS<sup>12</sup> ..... 11-LFQ-6
  - CDC<sup>13</sup> ..... 11-LYAW9
- Maximum Deformation ..... 102 mm at the front of the side panel
- Angular Displacement
  - Roll ..... 7 degrees
  - Pitch ..... -7 degrees
  - Yaw ..... 55 degrees

**Enclosure 2: Summary of Test Results and Sequential Photographs, Test 3-34**

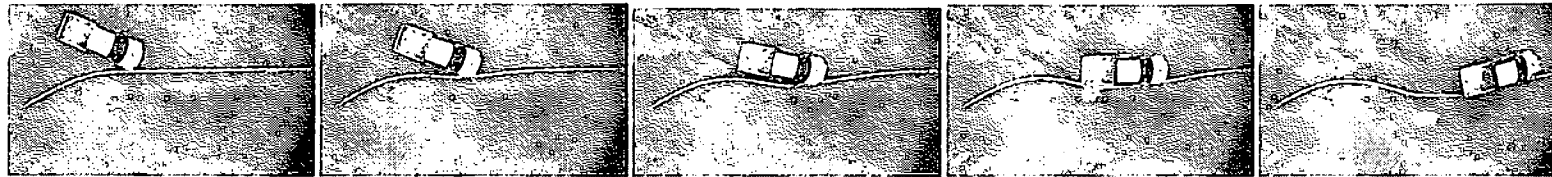

0.000 sec


0.058 sec

0.180 sec

0.268 sec


0.360 sec

- Test Agency ..... MwRSF
- Test Number ..... NYBBT-5
- Date ..... 7/31/08
- MASH Test Designation ..... 3-35
- Appurtenance ..... Modified Type IIA End Terminal
- Total Length ..... 40.2 m
- Key Element – Steel Box Beam
  - Size ..... 152 mm x 152 mm x 4.8 mm
  - Length ..... 5,486 mm
  - Top Mounting Height ..... 686 mm
- Key Elements - Steel Post
  - Post Nos. 1, 2, 4 ..... S76x8 5 by 2,134 mm long
  - Post Nos. 3, 5-26 ..... S76x8 5 by 1,600 mm long
- Type of Soil ..... Grading B - AASHTO M 147-65 (1990)
- Test Vehicle
  - Type/Designation ..... 2270P
  - Make and Model ..... 2002 Dodge Ram 1500 Quad Cab Pickup
  - Curb ..... 2,326 kg
  - Test Inertial ..... 2,276 kg
  - Gross Static ..... 2,354 kg
- Impact Conditions
  - Speed ..... 99.9 km/h
  - Angle (trajectory) ..... 23.6 degrees
  - Target Impact Location ..... Midspan between post nos. 8 and 9
  - Actual Impact Location ..... 863 mm upstream of post no. 9
- Exit Conditions
  - Speed ..... 81.1 km/h
  - Angle ..... 4 degrees
  - Exit Box Criterion ..... Pass
- Post-Impact Trajectory
  - Vehicle Stability ..... Satisfactory
  - Stopping Distance ..... 43.9 m downstream  
0.8 m laterally behind traffic-side face

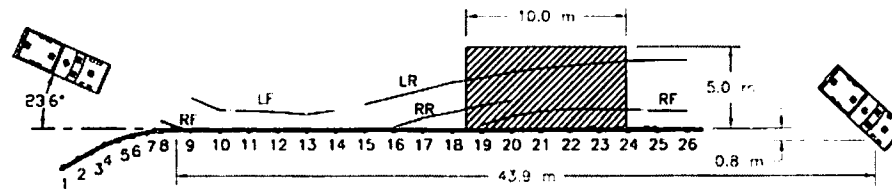

- Occupant Impact Velocity (EDR-3)
  - Longitudinal ..... -2.81 m/s < 12.2 m/s
  - Lateral ..... 4.12 m/s < 12.2 m/s
- Occupant Ridedown Acceleration (EDR-3)
  - Longitudinal ..... -4.85 g's < 20.49 g's
  - Lateral ..... 5.49 g's < 20.49 g's
- Occupant Impact Velocity (DTS)
  - Longitudinal ..... -2.78 m/s < 12.2 m/s
  - Lateral ..... 4.17 m/s < 12.2 m/s
- Occupant Ridedown Acceleration (DTS)
  - Longitudinal ..... -4.56 g's < 20.49 g's
  - Lateral ..... 6.51 g's < 20.49 g's
- THIV (DTS - not required) ..... 4.70 m/s
- PHD (DTS - not required) ..... 6.57 g's
- ASI (EDR-3 - not required) ..... 0.50
- ASI (DTS - not required) ..... 0.51
- Test Article Damage ..... Moderate
- Test Article Deflections
  - Permanent Set ..... 1,092 mm
  - Dynamic ..... 1,739 mm
  - Working Width ..... 2,504 mm
- Vehicle Damage ..... Moderate
  - VDS<sup>12</sup> ..... 01-RFQ-3
  - CDC<sup>13</sup> ..... 01-RDEN2
- Maximum Deformation ..... 13 mm at right-front floorboard
- Angular Displacement
  - Roll ..... -19 degrees
  - Pitch ..... -10 degrees
  - Yaw ..... 50 degrees

**Enclosure 3: Summary of Test Results and Sequential Photographs, Test 3-35**

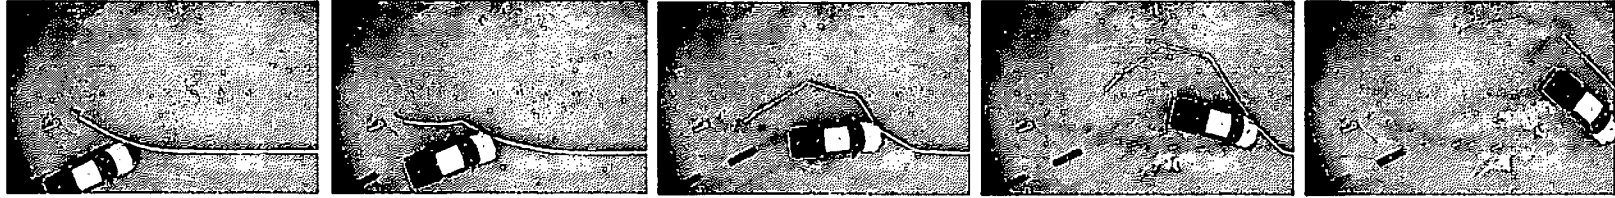

0.000 sec


0.094 sec

0.268 sec

0.446 sec

0.636 sec

- Test Agency ..... MwRSF
- Test Number ..... NYBBT-9
- Date ..... 8/6/09
- MASH Test Designation ..... Modified 3-35
- Appurtenance ..... Modified Type IIA End Terminal
- Total Length ..... 40.2 m
- Key Element – Steel Box Beam
  - Size ..... 152 mm x 152 mm x 4.8 mm
  - Length ..... 5,486 mm
  - Top Mounting Height ..... 686 mm
- Key Elements - Steel Post
  - Post Nos. 1, 2, 4 ..... S76x8.5 by 2,134 mm long
  - Post Nos. 3, 5-26 ..... S76x8.5 by 1,600 mm long
- Type of Soil ..... Grading B - AASHTO M 147-65 (1990)
- Test Vehicle
  - Type/Designation ..... 2270P
  - Make and Model ..... 2003 Dodge Ram 1500 Quad Cab Pickup
  - Curb ..... 2,283 kg
  - Test Inertial ..... 2,263 kg
  - Gross Static ..... 2,340 kg
- Impact Conditions
  - Speed ..... 101.9 km/h
  - Angle ..... 25.0 degrees
  - Target Impact Location ..... Centerline of vertical bolt at midpoint of rail at post no. 5
  - Actual Impact Location ..... 51 mm upstream of centerline of post no. 5
- Exit Conditions
  - Speed ..... 83.9 km/h
  - Angle ..... 31.0 degrees
  - Exit Box Criterion ..... NA
- Post-Impact Trajectory
  - Vehicle Stability ..... Satisfactory
  - Stopping Distance ..... 17.4 m downstream
  - ..... 6.8 m laterally behind traffic-side face
- Occupant Impact Velocity (EDR-3)
  - Longitudinal ..... -4.37 m/s < 12.2 m/s
  - Lateral ..... 3.03 m/s < 12.2 m/s

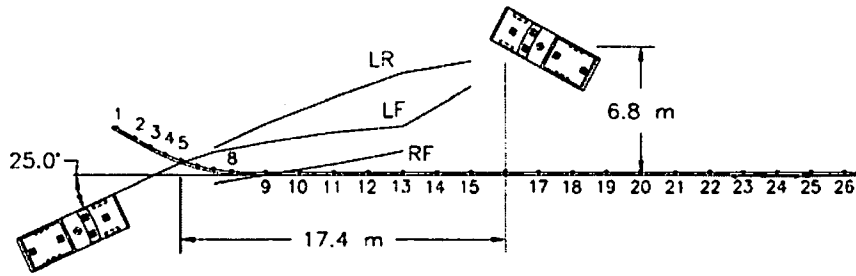

- Occupant Ridedown Acceleration (EDR-3)
  - Longitudinal ..... -7.77 g's < 20.49 g's
  - Lateral ..... 4.38 g's < 20.49 g's
- Occupant Impact Velocity (DTS)
  - Longitudinal ..... -4.41 m/s < 12.2 m/s
  - Lateral ..... 2.81 m/s < 12.2 m/s
- Occupant Ridedown Acceleration (DTS)
  - Longitudinal ..... -7.37 g's < 20.49 g's
  - Lateral ..... 4.84 g's < 20.49 g's
- THIV (DTS - not required) ..... 4.84 m/s
- PHD (DTS - not required) ..... 7.67 g's
- ASI (EDR-3 - not required) ..... 0.82
- ASI (DTS - not required) ..... 0.73
- Test Article Damage ..... Extensive due to gating
- Test Article Deflections
  - Permanent Set ..... 1,080 mm
  - Dynamic ..... NA
  - Working Width ..... 17,820 mm
- Vehicle Damage ..... Moderate
  - VDS<sup>12</sup> ..... 11-LFQ-3
  - CDC<sup>13</sup> ..... 11-LFEW8
- Maximum Deformation ..... 19 mm at the left side of the dashboard
- Angular Displacement
  - Roll ..... -22 degrees
  - Pitch ..... -5 degrees
  - Yaw ..... 236 degrees

**Enclosure 4: Summary of Test Results and Sequential Photographs, Test modified 3-35**